



1. Choke: to slow speeds
2. Rolling Grade Dip
3. Reroute, 0.12 mi:
 - Fall Line
 - Knee to chest deep channel
 - Speed reduction
4. Drain
4. Choke: to slow speeds
5. Reroute, 0.52 mi:
 - Trail is an ephemeral stream
 - 5.1 Fall line
 - 5.2 Wetland
6. Stream crossing: armor
7. Reroute, 0.15 mi: ditch and drain
 - Move to higher ground and use existing trail as ditch
8. Stream crossing: armor

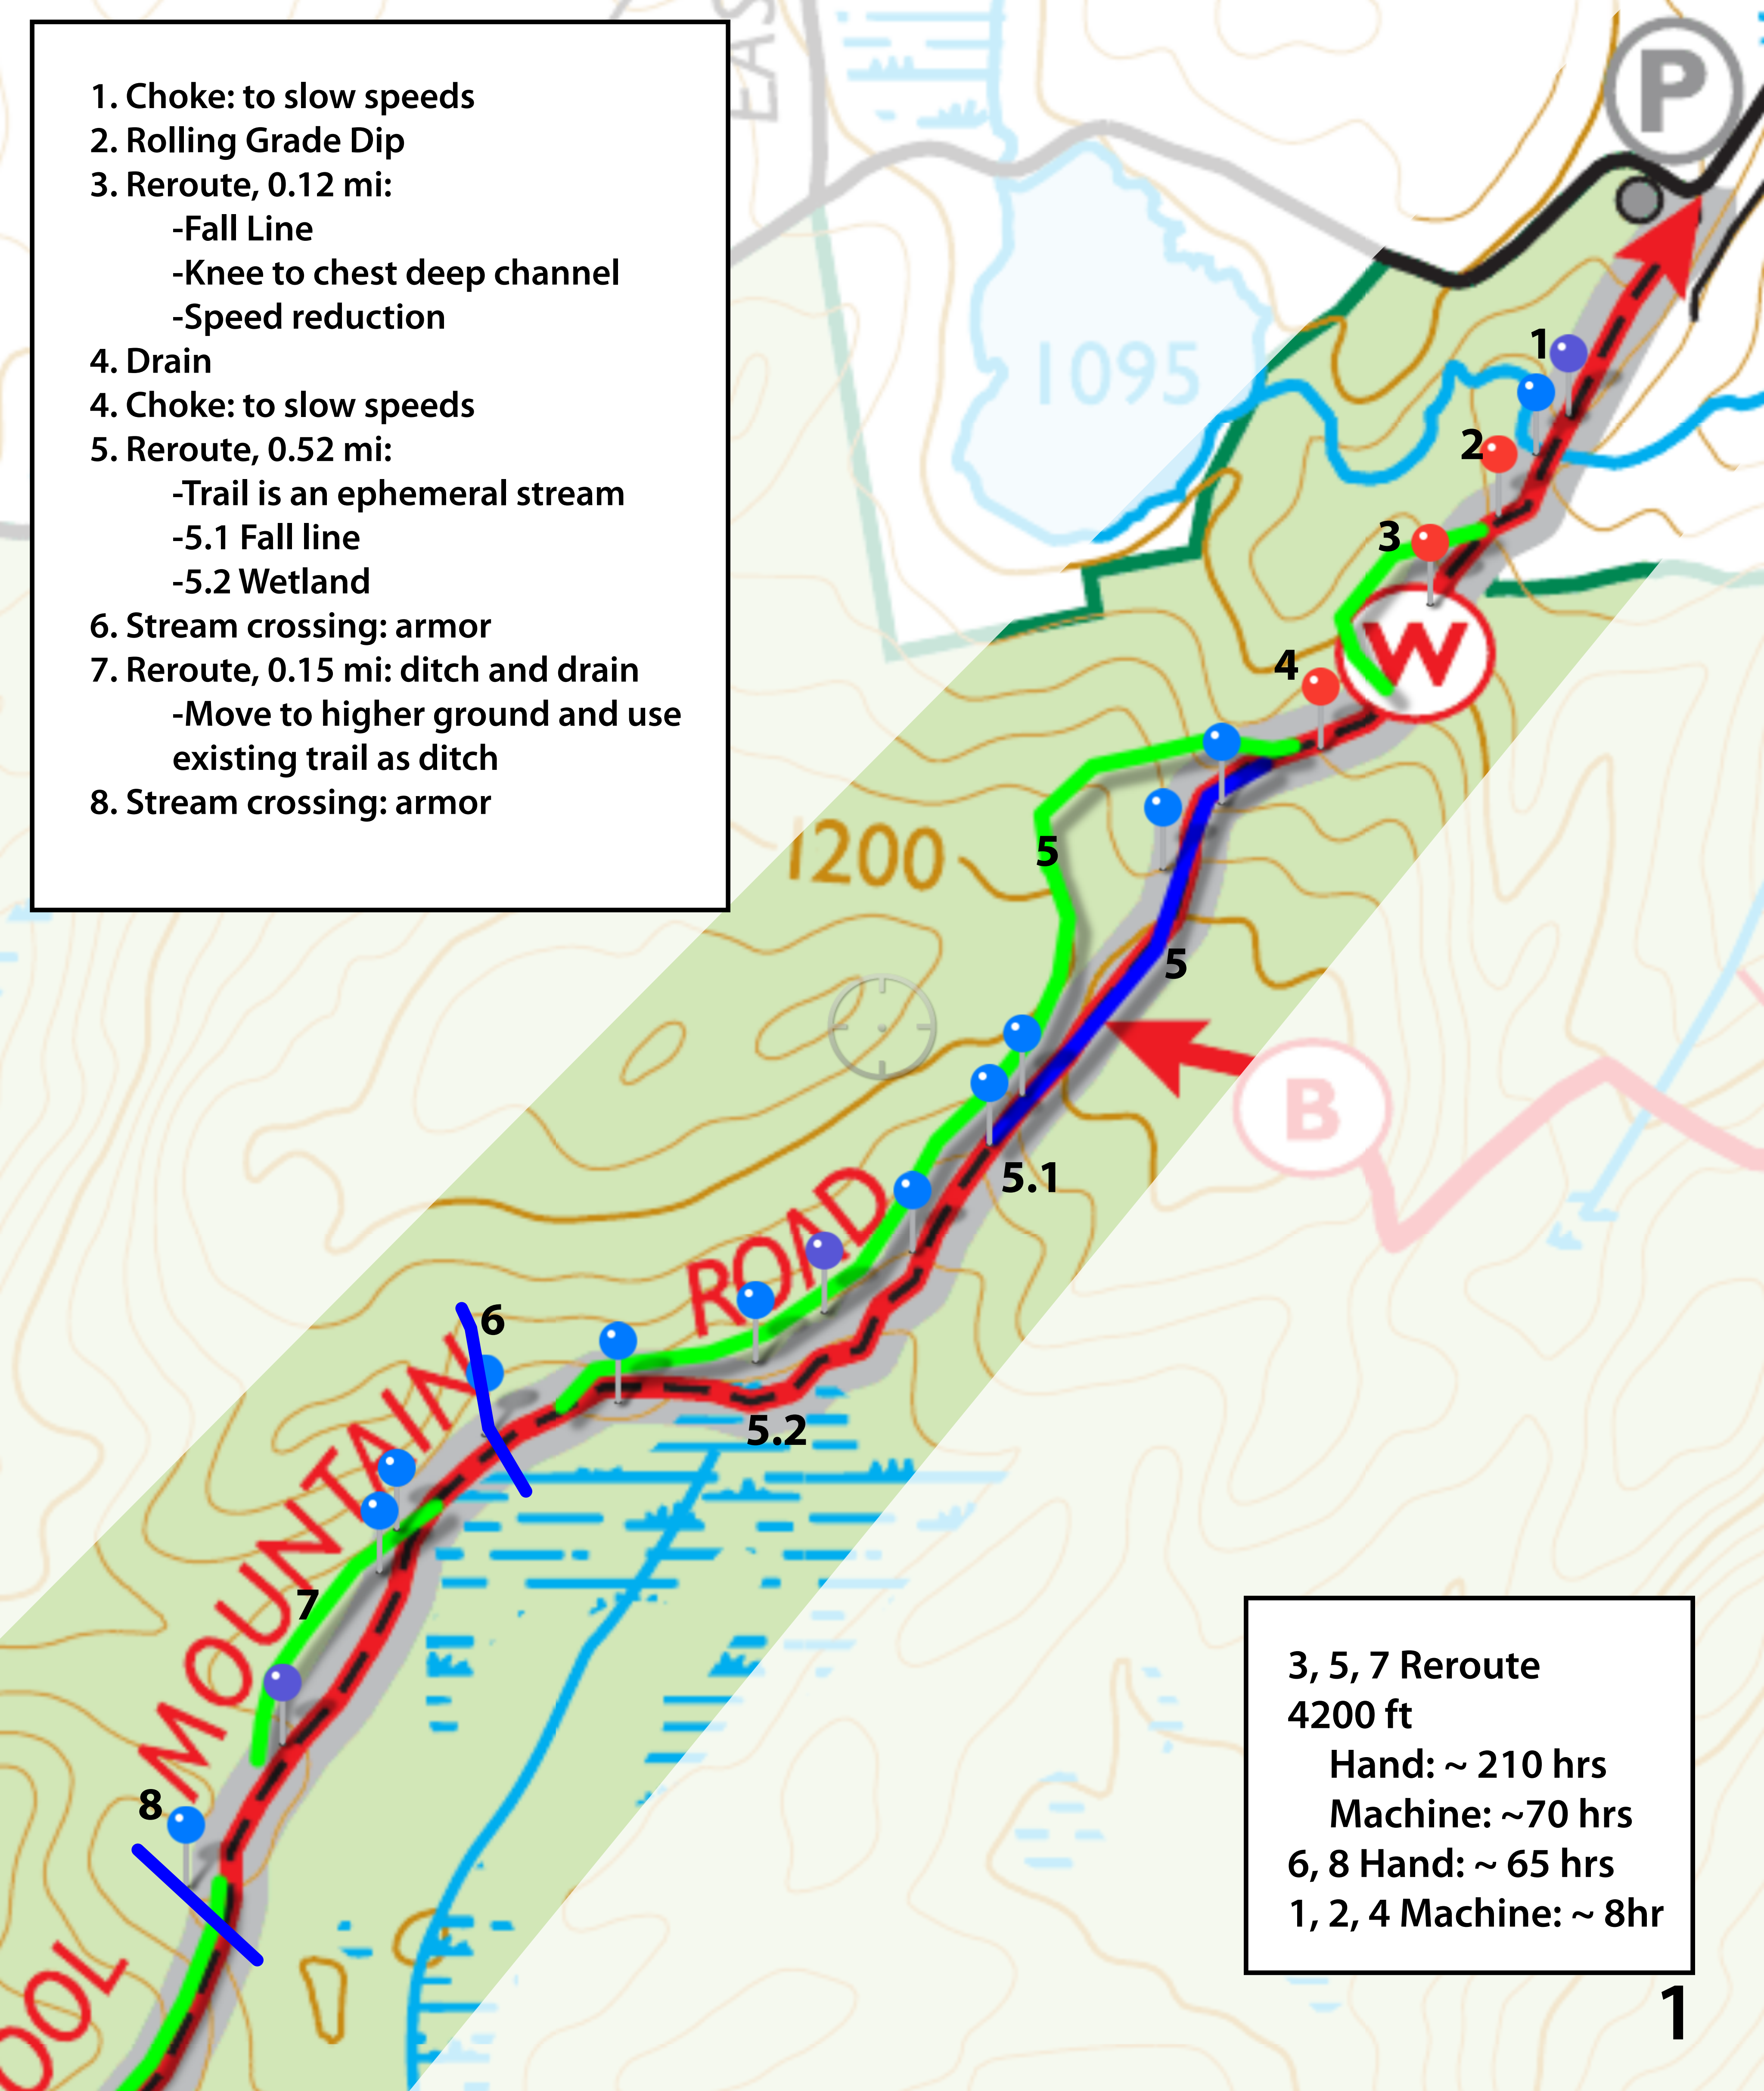

3, 5, 7 Reroute
 4200 ft
 Hand: ~ 210 hrs
 Machine: ~70 hrs
 6, 8 Hand: ~ 65 hrs
 1, 2, 4 Machine: ~ 8hr

- 9. Choke: to slow speeds
- 9. Rolling Grade Dip
- 10. Reroute, 0.3 mi: ditch and drain
- 11. Reroute, 0.18 mi:
 - Fall line
 - Green reroute is actually to right of red trail, red line is off
- 12. Trail is stream
- 13. Stream
 - Armor; monitor to determine culvert need
- 14. Reroute, 0.63 mi:
 - Fall line to right of 14.2
 - Begins after 13 to start losing elevation
 - 14.1 0.15 mi: option to starting at 13, but more work, and includes switchbacks
 - 14.2 abandoned
- 15. Reroute for Perkins
 - 15.1 0.24 mi: optional, second choice, more sensible if 14.1 is built
- 16 - 20, 22. Rolling grade dip
- 21. Deberm, and outslope

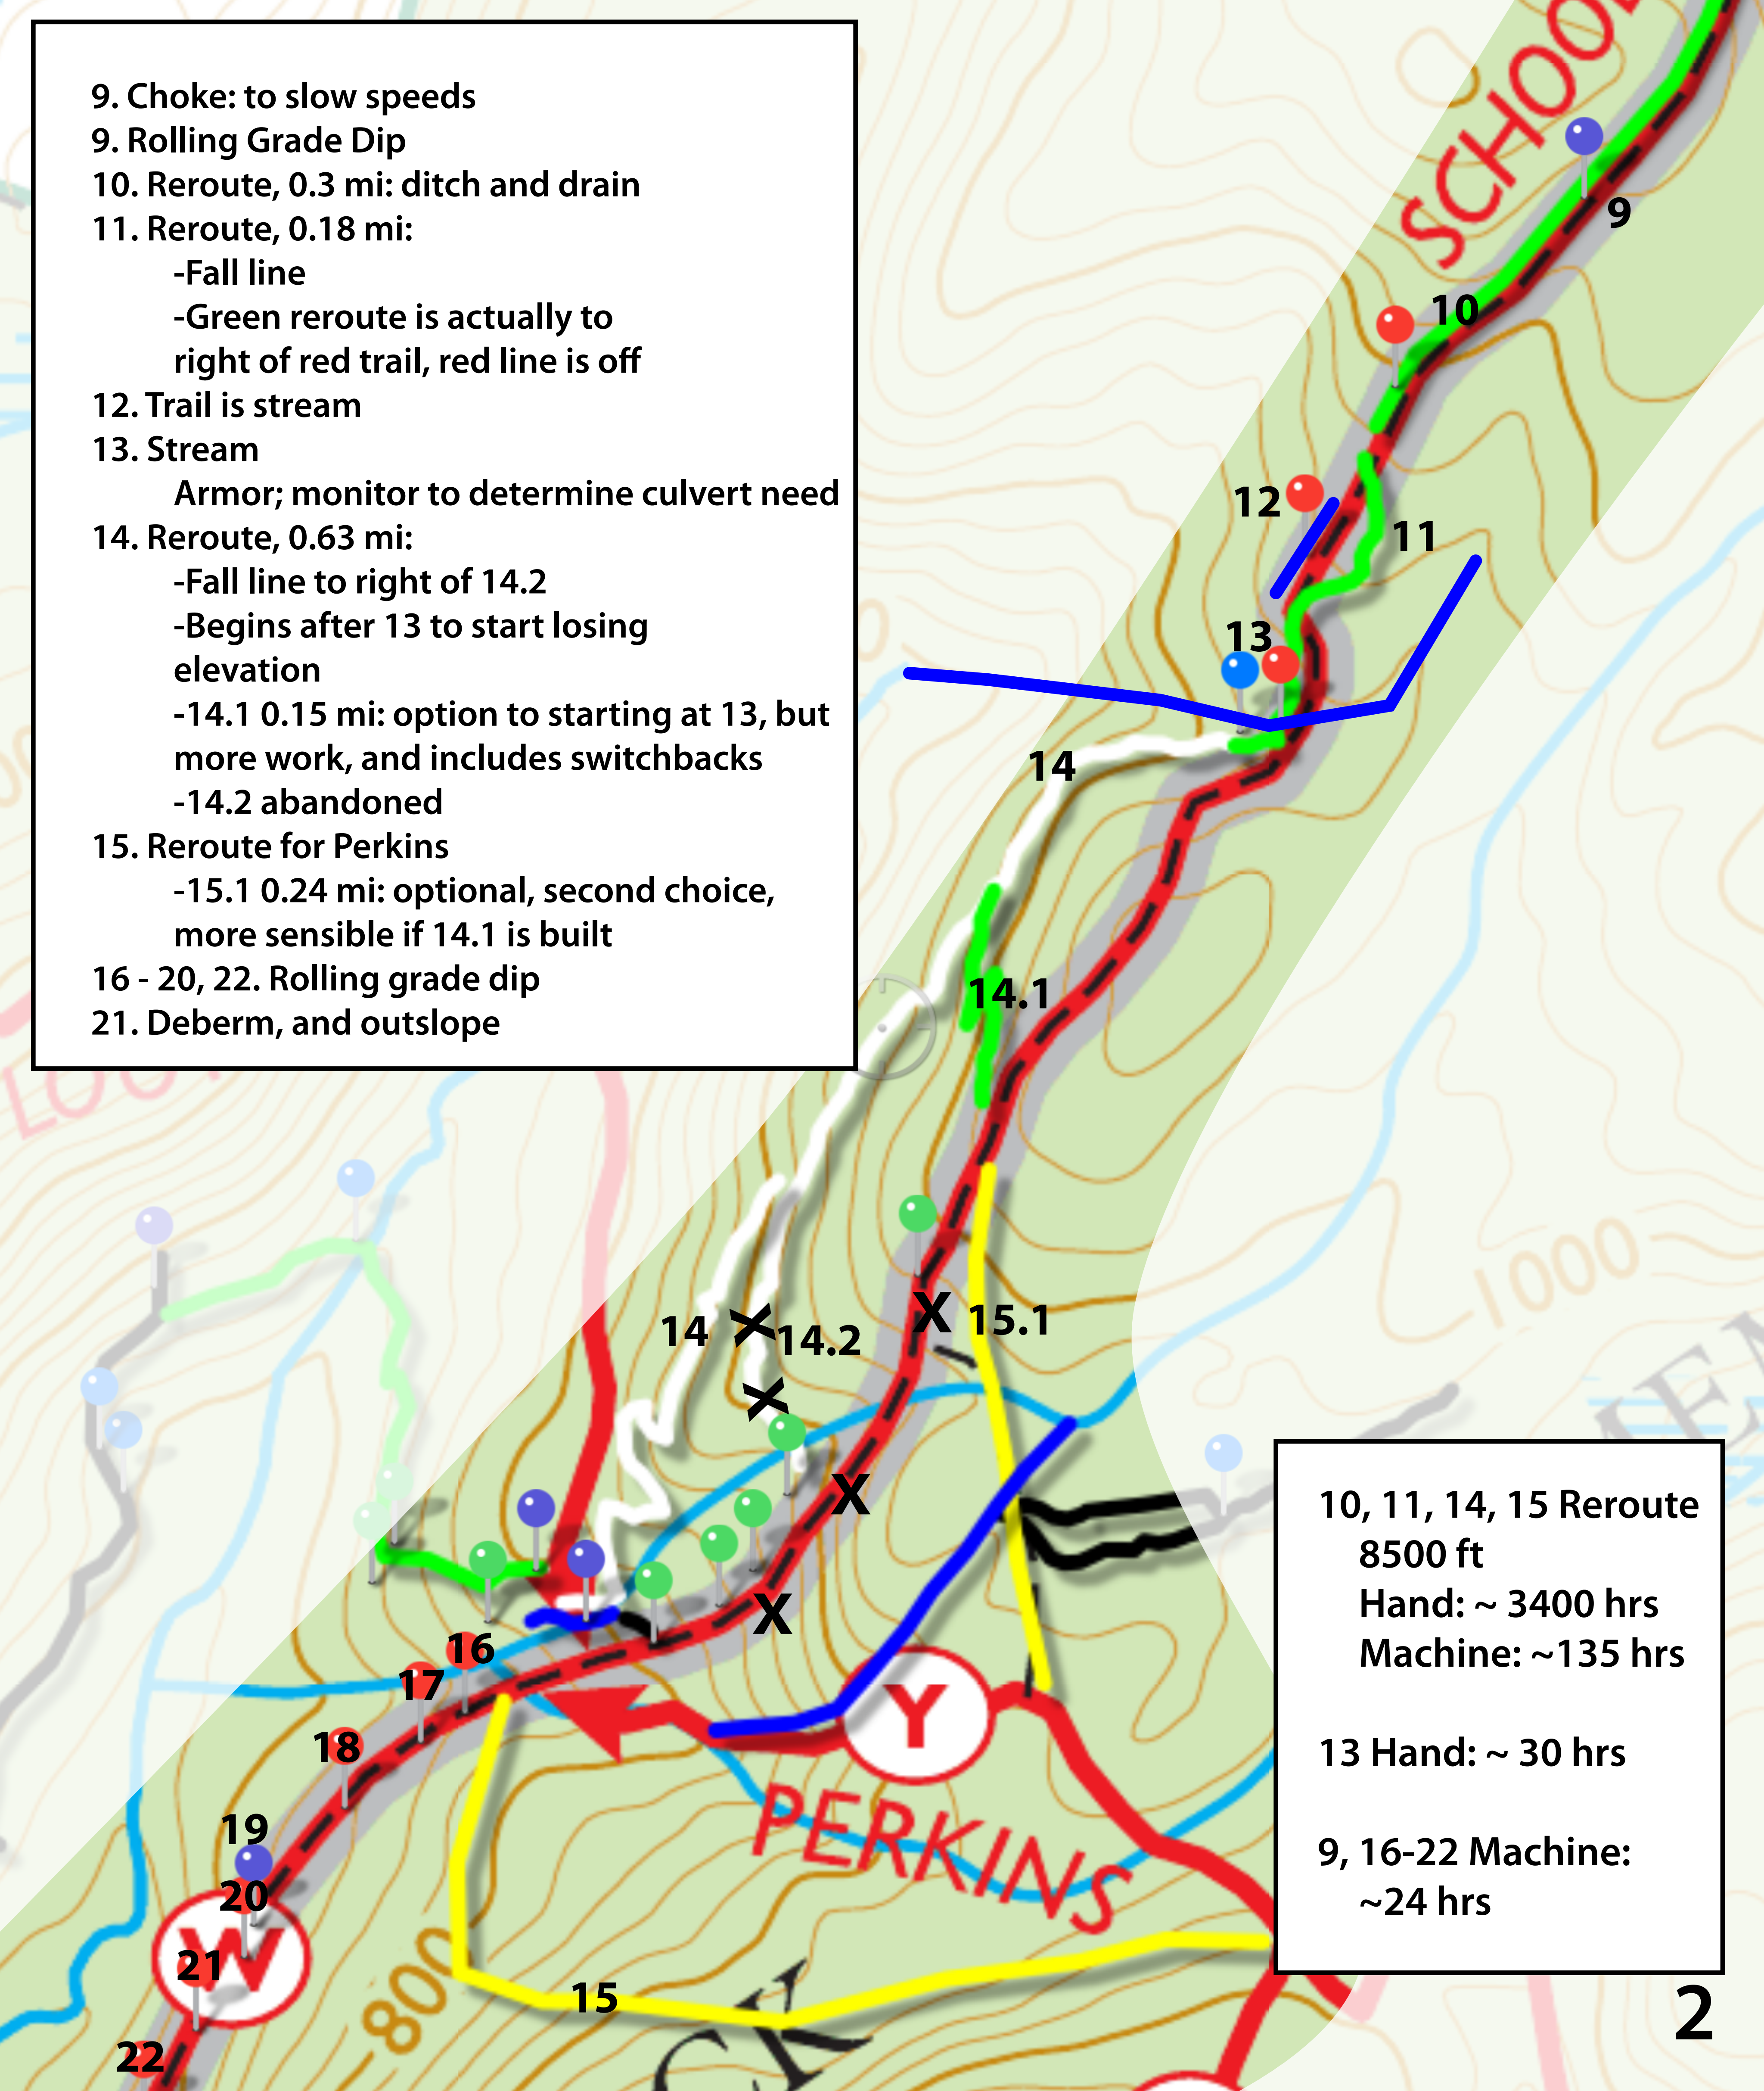


10, 11, 14, 15 Reroute
 8500 ft
 Hand: ~ 3400 hrs
 Machine: ~135 hrs

13 Hand: ~ 30 hrs

9, 16-22 Machine:
 ~24 hrs

23 - 27. Rolling Grade Dip
28. Reroute, 0.06 mi: to eliminate need for
bridge 6 and 7 for East Mountain trail
29 - 33. Rolling Grade Dip

Bridge 6: see notes
Bridge 7: see notes

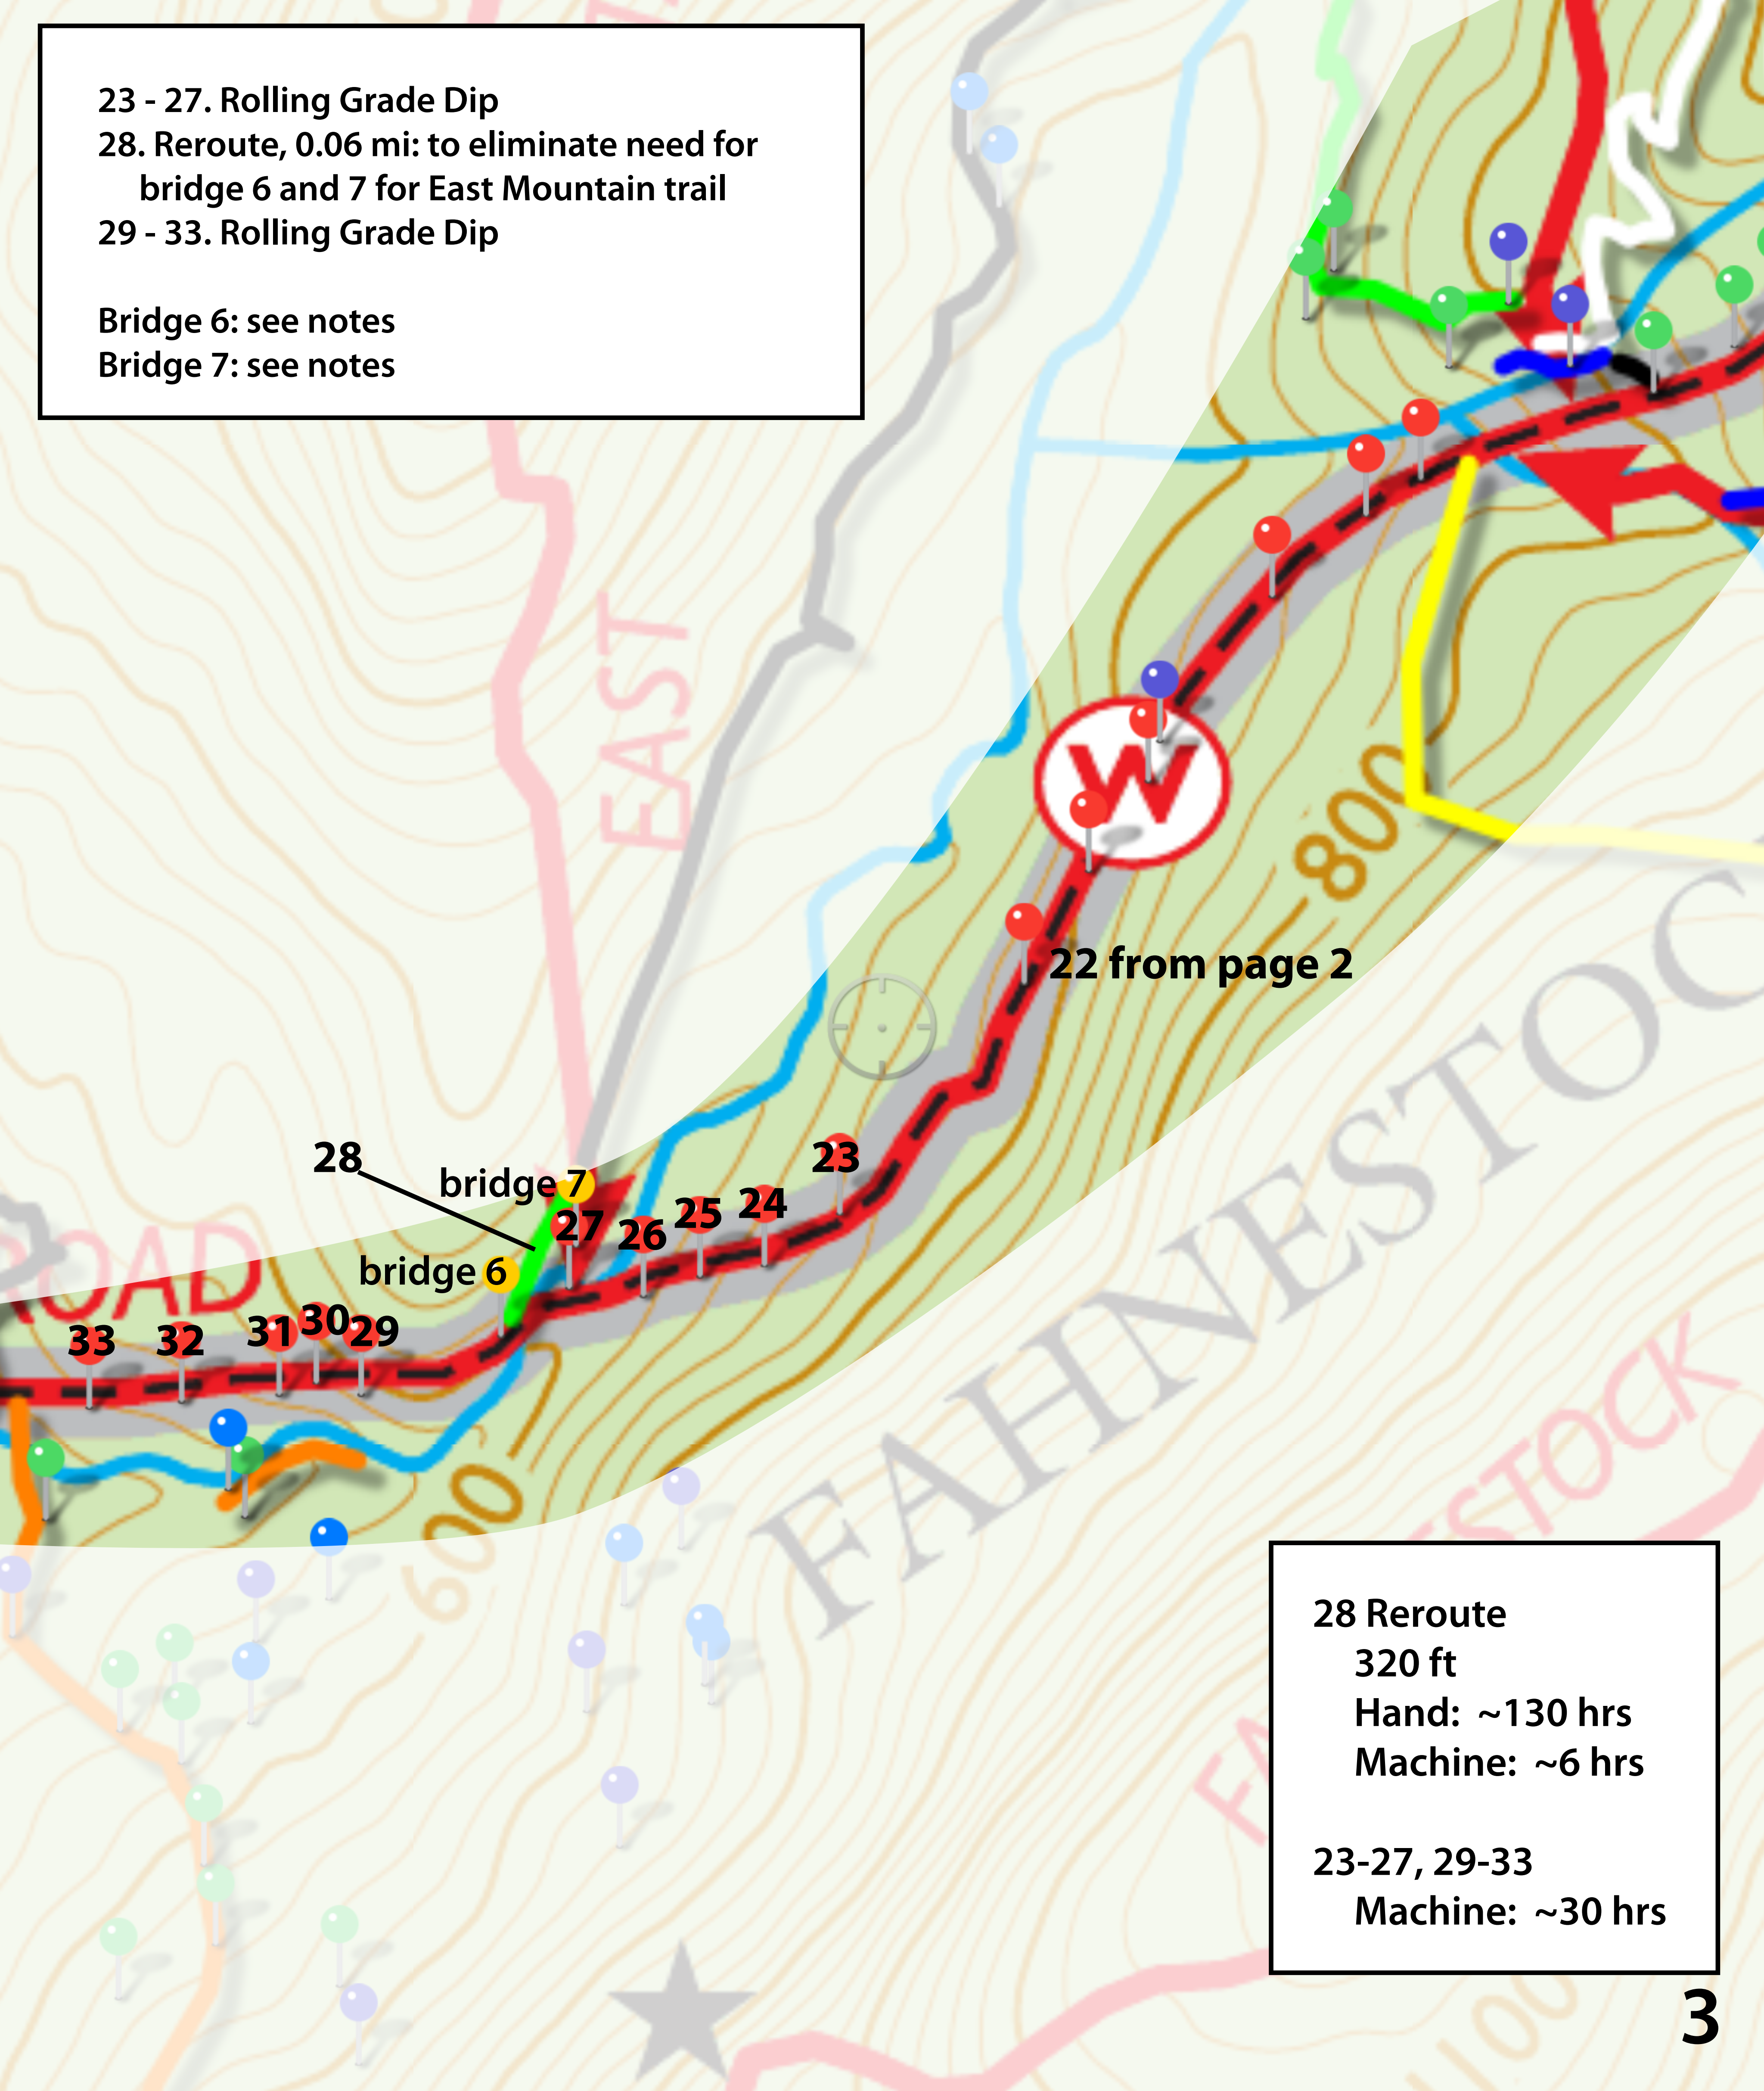

22 from page 2

28
bridge 7
27
bridge 6
26
25
24
23

33
32
31
30
29

28 Reroute
320 ft
Hand: ~130 hrs
Machine: ~6 hrs

23-27, 29-33
Machine: ~30 hrs

34 -36. Rolling Grade Dip

37. Reroute, 0.03 mi: lower crossing upstream

Bridge 4: see notes

Bridge 3: see notes

bridge 5

33 from page 3

bridge 4

34

35

36

Bridge 3 relocation
Reroute

34-36

Machine: ~ 8 hrs

37 Reroute

160 ft

Hand: ~64 hrs

Machine: ~2 hrs

38. Drain and outslope
39. Rolling Grade Dip

Bridge 1: see notes
Bridge 2: see notes

Bridge out,
crossing may
be difficult

bridge 4

36 from page 4

bridge 3

37
38

bridges 2
1

38-39
Machine: ~ 6 hrs

